
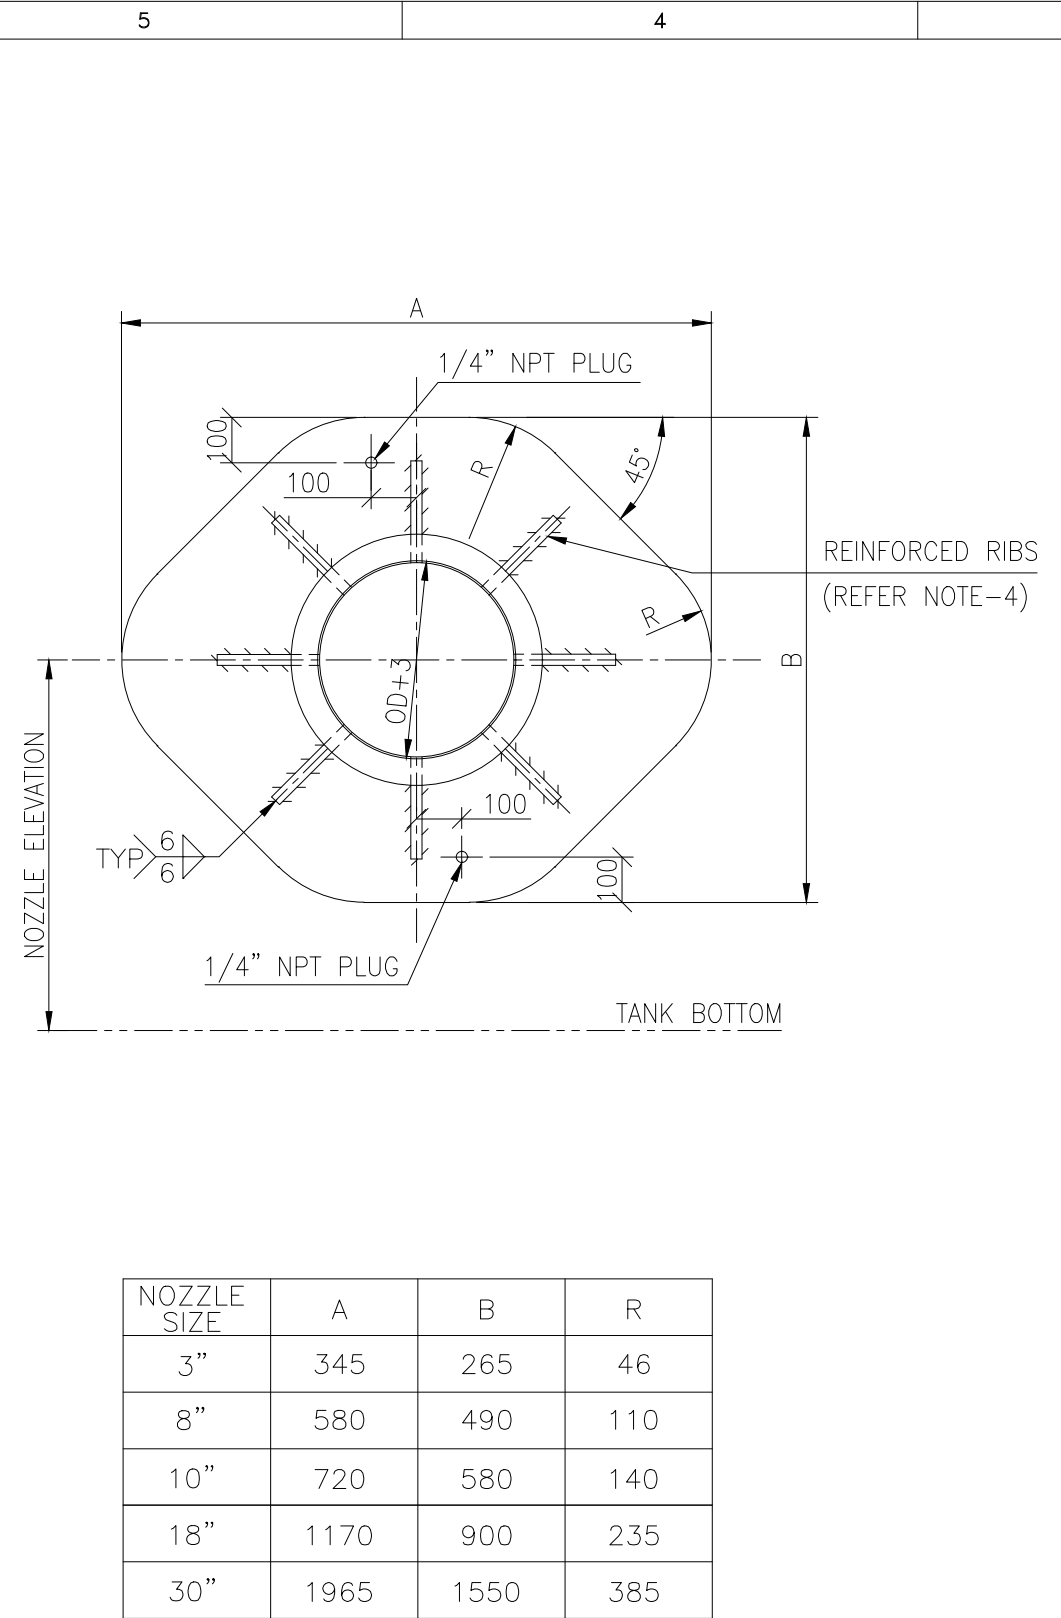
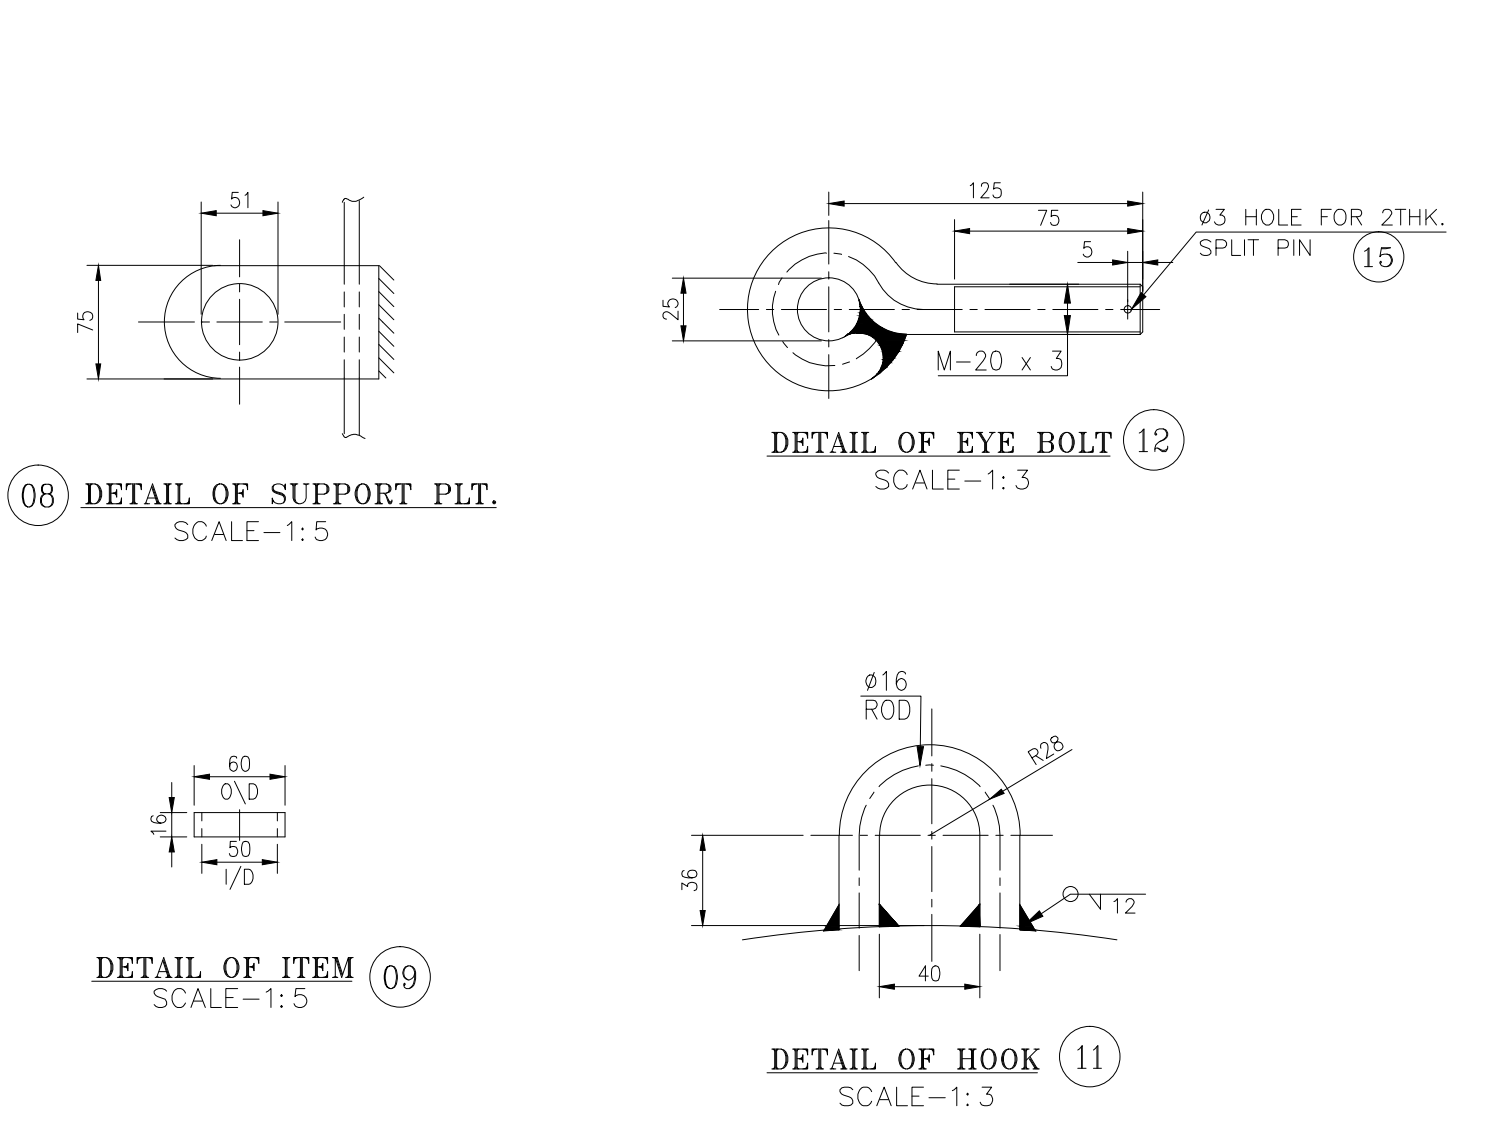
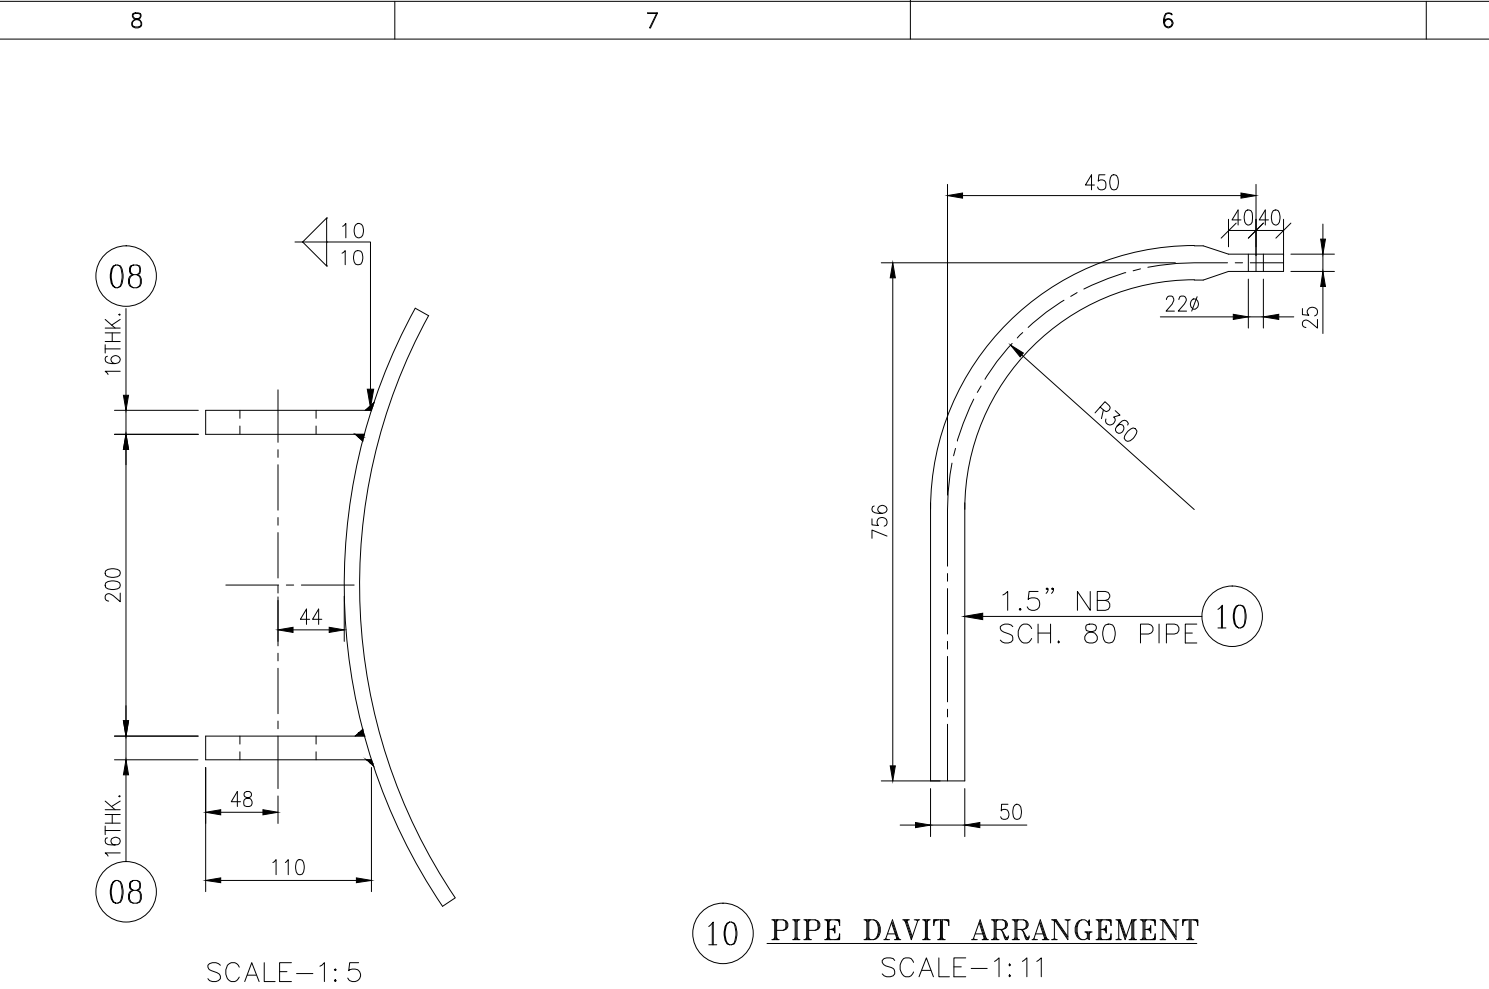
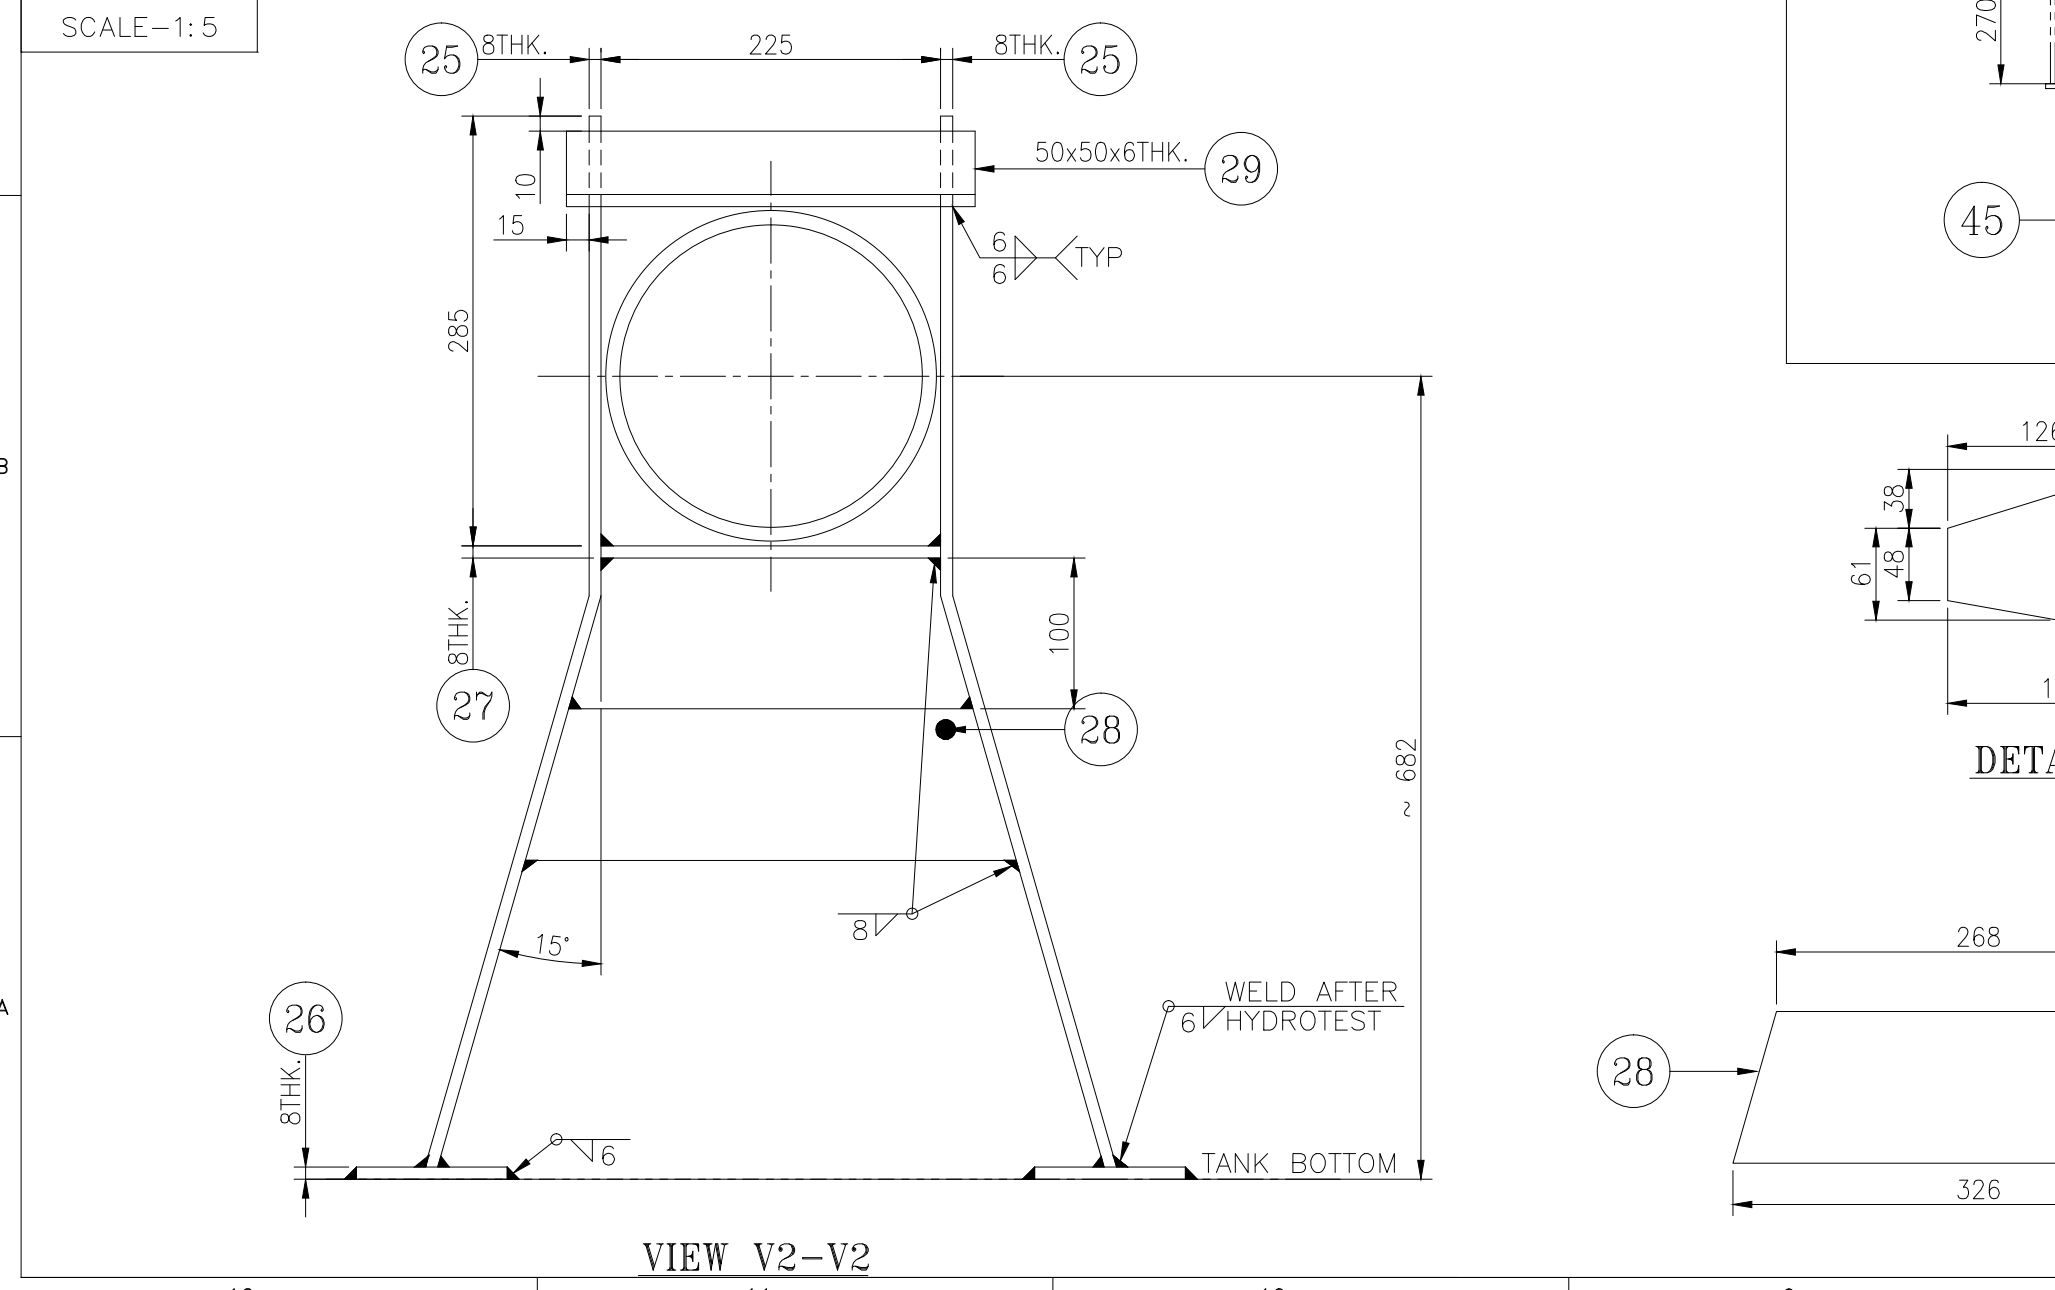
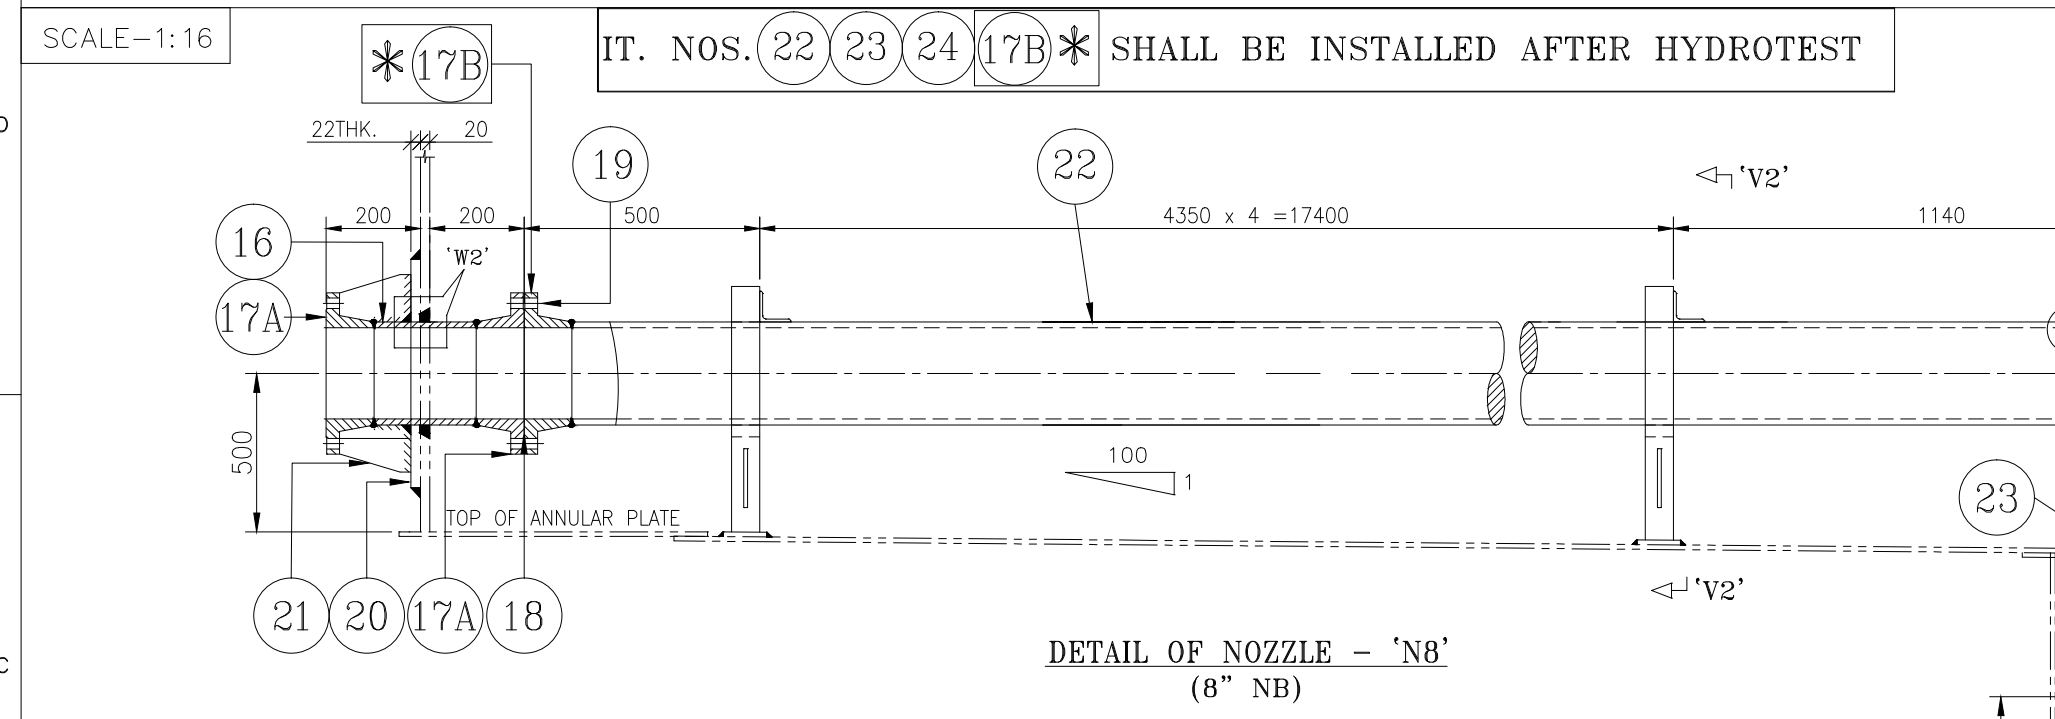
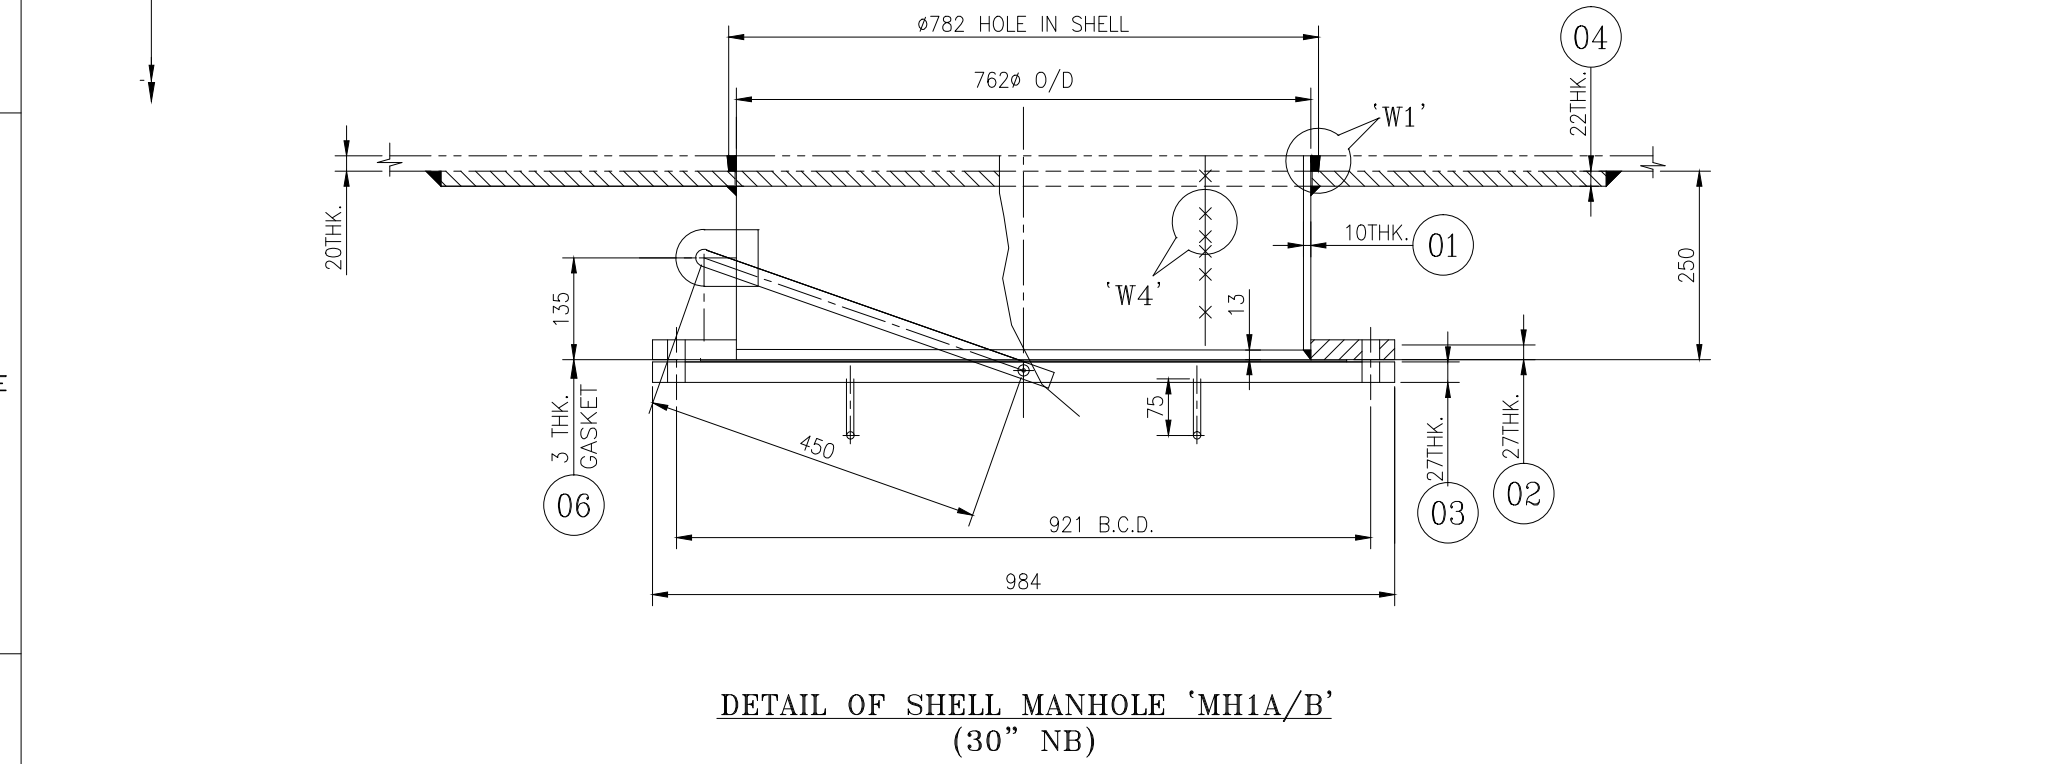


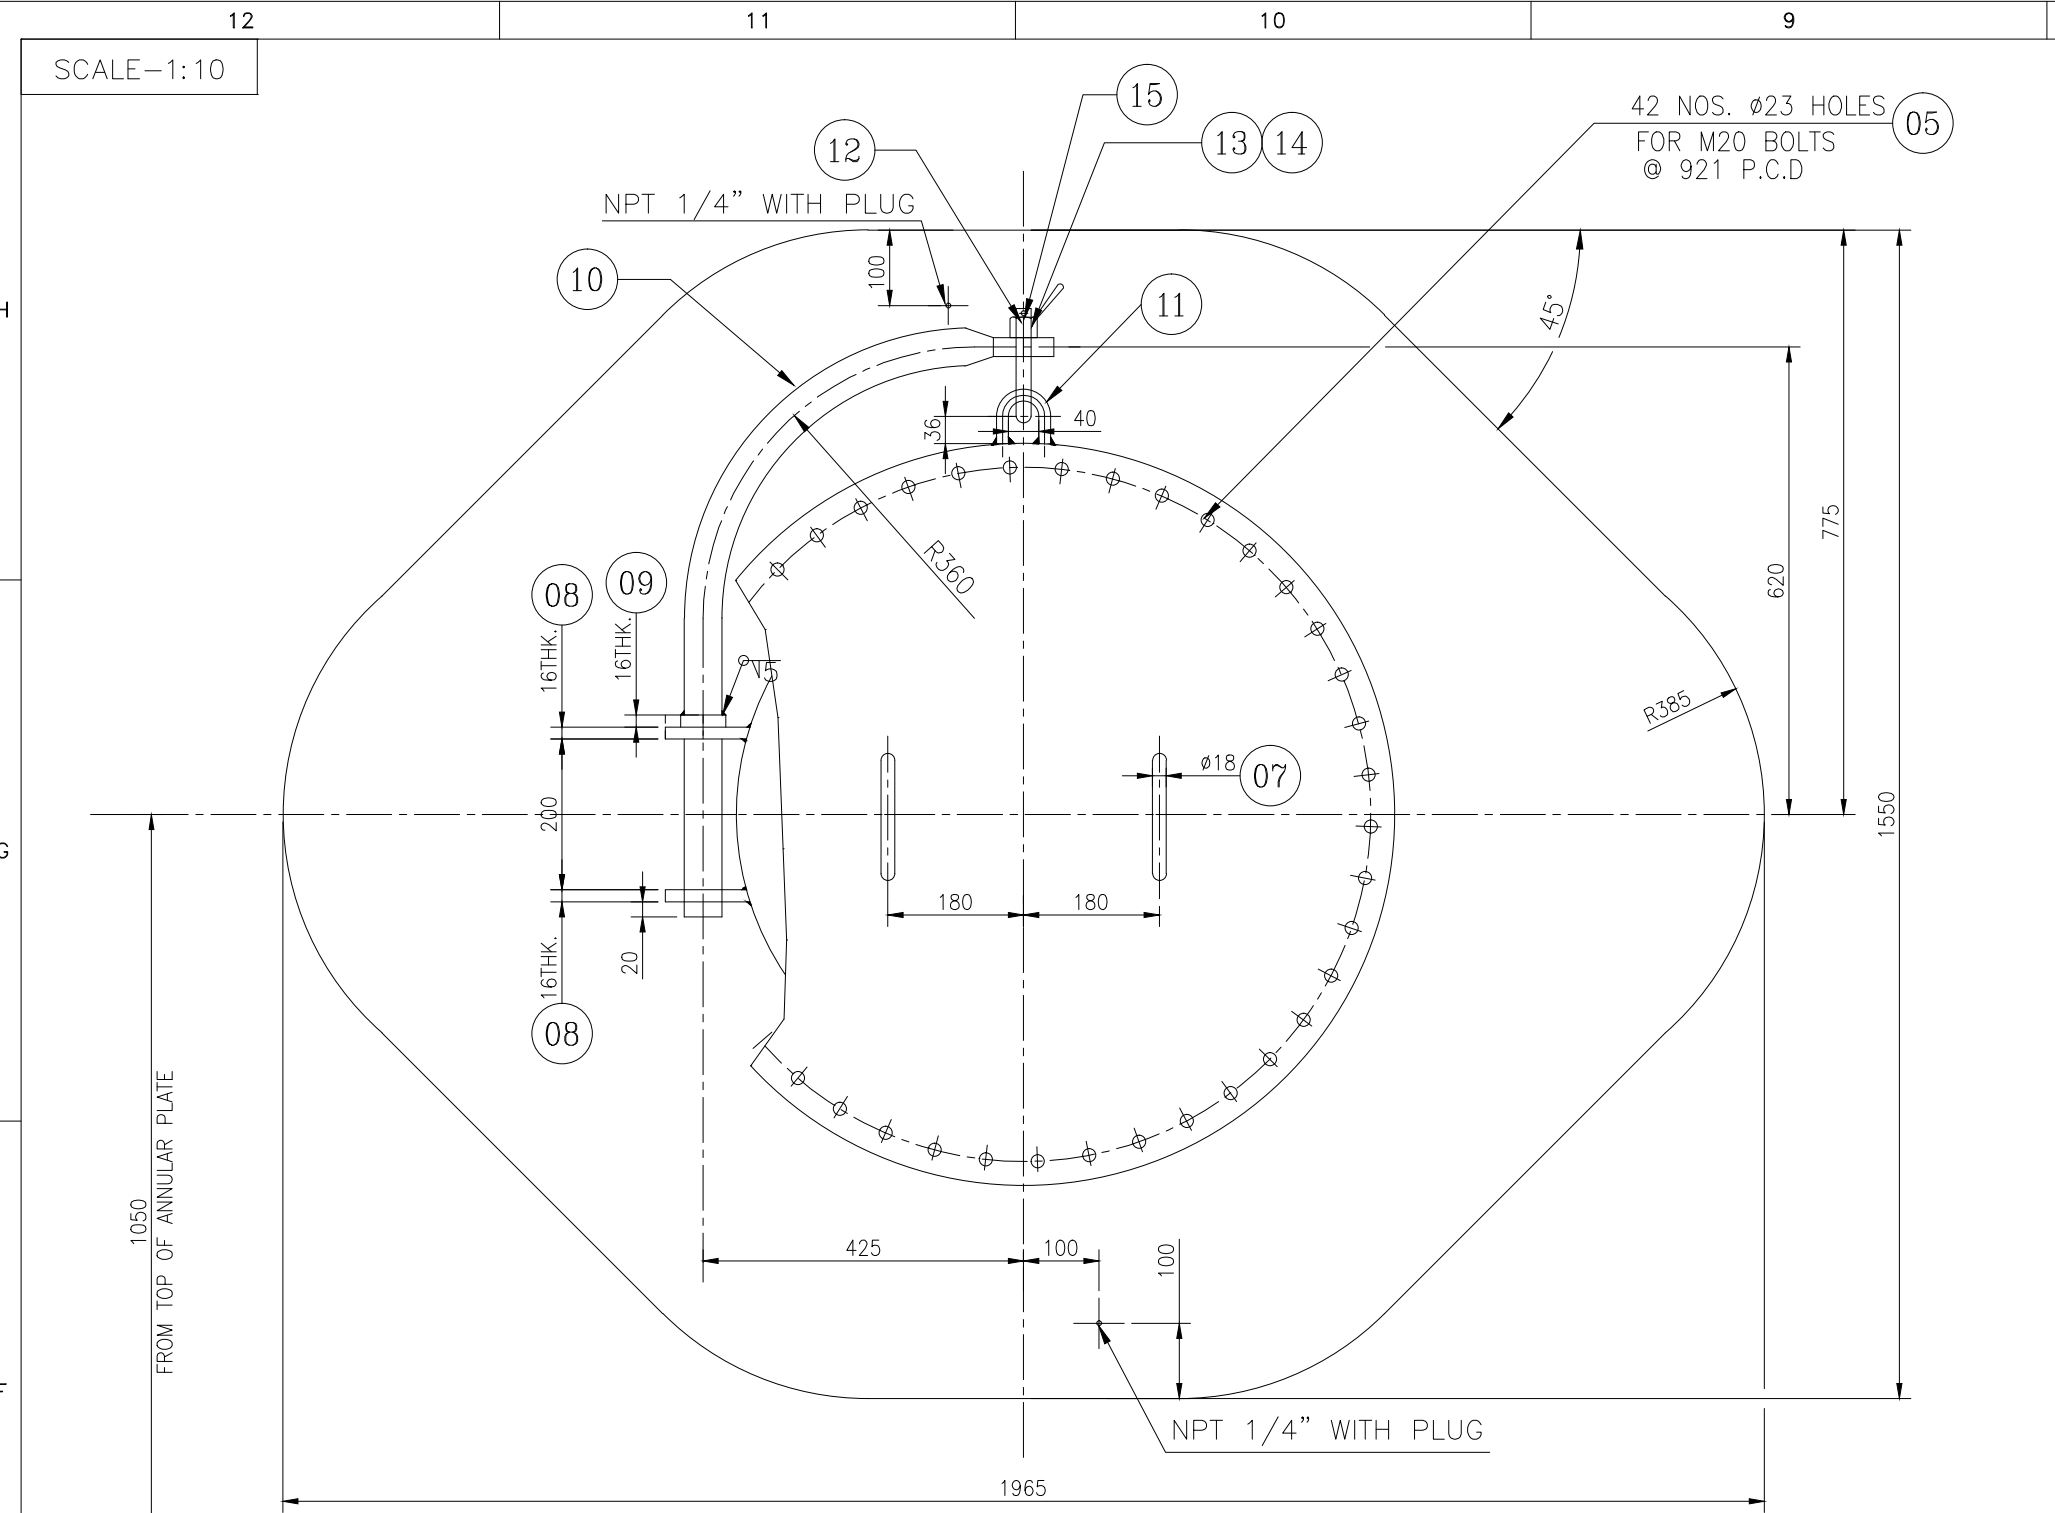

NOTES :

- ALL DIMENSIONS ARE IN mm. UNLESS OTHERWISE SPECIFIED.
- FOR GENERAL NOTE REFER G.A. DRG. NO.: 13B1A46-00-02-GA-501
- NECK WELD JOINT FABRICATED FROM PLATE SHALL BE RADIOGRAPHED 100%
- FOR 3" NB SIZE NOZZLE, NO. OF RIBS SHALL BE 4 NOS. ONLY & FOR OTHER SIZE OF NOZZLES RIBS SHALL BE 8 NOS. ONLY.
- READ THIS DRAWING IN CONJUNCTION WITH DRG. NO.: 13B1A46-00-02-DWG-507 (SHT. 2 & 3 OF 3)

TOTAL WT. IN Kg. : 2547

ITEM NO.	DESCRIPTION	QTY.	DIMENSION	MATERIAL	WEIGHT	REMARK
46	VORTEX BREAKER PLATE N8	2	8 THK. x AS SHOWN	IS-2062 Gr.B	5.4	
45	VORTEX BREAKER PLATE N8	1	8 THK. x AS SHOWN	IS-2062 Gr.B	5.4	
44	ELBOW	N5 01	3" NB; SCH.80; 45° L.R.	A 234 GR WPB	1.34	
43	ANGLE	N5 6	L50 x 50 x 6THK.- 146LG.	IS-2062 Gr.A	3.94	
42	RIB PLATE	N5 6	8 THK. x AS SHOWN	IS-2062 Gr.B	6.30	
41	PLATE	N5 6	8 THK. x 60 x 100	IS-2062 Gr.B	2.30	
40	PAD PLATE	N5 12	8 THK. x 100 x 100	IS-2062 Gr.B	7.54	
39	FLATE PLATE	N5 12	8 THK. x 60 x ~694 LG.	IS-2062 Gr.A	31.38	
38	ELBOW	N5 1	3" NB; SCH.80; 90° L.R.	A 234 GR WPB	2.69	
37	PIPE	N5 1	3" NB; SCH.80; 806 LG.	A 106 GR.B	12.31	
36	PIPE	N5 1	3" NB; SCH.80; 19005 LG.	A 106 GR.B	290.21	
35	RIB	N5 4	6 THK. x AS SHOWN	IS-2062 Gr.B	1.56	
34	R.F.PAD	N5 1	22 THK. x AS SHOWN	IS-2062 Gr.B	10.12	CTS
33	NUTS/BOLTS	N5 4	M16 x 80 LG.	A-193 GR.B7/ A-194 GR. 2H	-	
32	GASKET	N5 1	3 THK. x TO SUIT 3" NB	CNAF	-	
31	FLANGE	N5 3	3" NB 150# W.N.R.F. SCH.80	A 105	13.80	
30	NECK	N5 1	3" NB; SCH.80; 230 LG.	A 106 GR.B	3.51	
29	ANGLE	N8 5	L50 x 50 x 6THK.- 271LG.	IS-2062 Gr.A	6.10	
28	RIB PLATE	N8 5	8 THK. x AS SHOWN	IS-2062 Gr.B	7.00	
27	PLATE	N8 5	8 THK. x 60 x 225	IS-2062 Gr.B	4.25	
26	PAD PLATE	N8 10	8 THK. x 100 x 100	IS-2062 Gr.B	6.30	
25	FLAT PLATE	N8 10	8 THK. x 60 x ~862 LG.	IS-2062 Gr.A	32.48	
24	ELBOW	N8 1	8" NB; SCH.40; 90° L.R.	A 234 GR WPB	20.4	
23	PIPE	N8 1	8" NB; SCH.40; 595 LG.	A 106 GR.B	25.31	
22	PIPE	N8 1	8" NB; SCH.40; 18631 LG.	A 106 GR.B	792.56	
21	RIB	N8 08	6 THK. x AS SHOWN	IS-2062 Gr.B	4.56	
20	R.F.PAD	N8 01	22 THK. x AS SHOWN	IS-2062 Gr.B	29.16	CTS
19	NUTS/BOLTS	N8 8	M20 x 90 LG.	A-193 GR.B7/ A-194 GR. 2H	-	
18	GASKET	N8 1	3 THK. x TO SUIT 8" NB	CNAF	-	
17B	FLANGE	N8 01	8" NB 150# W.N.R.F. SCH.40	A 105	18.5	
17A	FLANGE	N8 02	8" NB 150# W.N.R.F. SCH.80	A 105	37	
16	NECK	N8 1	8" NB; SCH.80; 230 LG.	A 106 GR.B	14.15	
15	SPLIT PIN	MH A/B 2	2 THK. x TO SUIT	S.S	-	
14	WASHER	MH A/B 2	2 THK. FOR M20	IS-2062 Gr.A	-	
13	NUTS	MH A/B 2	M 20	A-194 GR. 2H	-	
12	EYE BOLT	MH A/B 2	M 20 x AS SHOWN	IS-2062 Gr.A	-	
11	HOOK	MH A/B 2	Ø16 x 165 LG.	IS-2062 Gr.A	0.52	
10	PIPE	MH A/B 2	1.5" NB x SCH. 80 x ~1100 LG.	A 106 GR.B	11.90	
9	WASHER	MH A/B 2	16 THK. x 60 OD x 50 ID	IS-2062 Gr.A	0.22	
8	SUPPORT PLATE	MH A/B 4	16 THK. x 75 x 110 LG.	IS-2062 Gr.B	4.14	
7	HANDLE	MH A/B 4	Ø18 x 360 LG.	IS-2062 Gr.A	2.88	
6	GASKET	MH A/B 2	3 THK x 899 OD x 762 ID	CNAF	-	
5	BOLTS W/NUTS	MH A/B 84	M 20 x 90 LG.	A-193 GR.B7/ A-194 GR. 2H	-	
4	R.F.PAD	MH A/B 2	22 THK. x AS SHOWN	IS-2062 Gr.B	569.03	CTS
3	COVER FLANGE	MH A/B 2	28 THK. x 984 OD	IS-2062 Gr.B	334.30	INCLUDING MACHINING ALLOWANCE
2	BOLTING FLANGE	MH A/B 2	28 THK. x 984 OD x 765 ID	IS-2062 Gr.B	132.25	
1	NECK	MH A/B 2	10 THK. x ~275 x 2362 LG.	IS-2062 Gr.B	96.04	

BILL OF MATERIAL FOR ONE TANK

REFERENCE DRAWINGS

SR. NO.	DWG TITLE	DWG NO.
1	GENERAL ARRANGEMENT	13B1A46-00-02-GA-501
2	SHELL PLATE LAYOUTS	13B1A46-00-02-DWG-502 2 SHEETS
3	DETAILS OF SHELL APPURTENANCES	13B1A46-00-02-DWG-507 (SHT. 2 OF 3)
4	DETAILS OF NOZZLE 'N1'	13B1A46-00-02-DWG-507 (3 OF 3)

AS BUILT

REV.	DATE	DESCRIPTION	DRAWN	ENG	CHK	APPROVED
F1	05.10.2015	ISSUED AS BUILT	DGK	AS	RAVI	RV
C3	23.06.2014	ISSUED FOR CONSTRUCTION	PPS	AS	RAVI	RV
C2	05.03.2014	ISSUED FOR CONSTRUCTION	RAVI	MP	MP	RV
C1	10.02.2014	ISSUED FOR CONSTRUCTION WITH HOLD	SSK	MP	MP	RV

REVISION SUMMARY

PROJECT : COMMON USERS POL TERMINAL LAKHOLI, RAIPUR, CHATTISGARH

OWNER:-- IOT INFRASTRUCTURE & ENERGY SERVICES LTD

EPC CONTRACTOR:-- IOT ANWESHA ENGINEERING & CONSTRUCTION LTD.

ENGINEERING CONSULTANT:-- IOT D&E IOT DESIGN & ENGINEERING LTD. MUMBAI

PROJ. NO.:	SJ-203	TITLE :	DETAILS OF SHELL APPURTENANCES FOR MS PIPELINE RECEIPT STORAGE SINGLE DECK INTERNAL FLOATING ROOF TANKS (39.0 M I.D. x 20.0 M HT.) (T-03 A/B)	SHEET	REV.
SHEET SIZE :	A1	DWG NO. :	13B1A46-00-02-DWG-507	1 OF 3	F1
SCALE :	AS SHOWN				