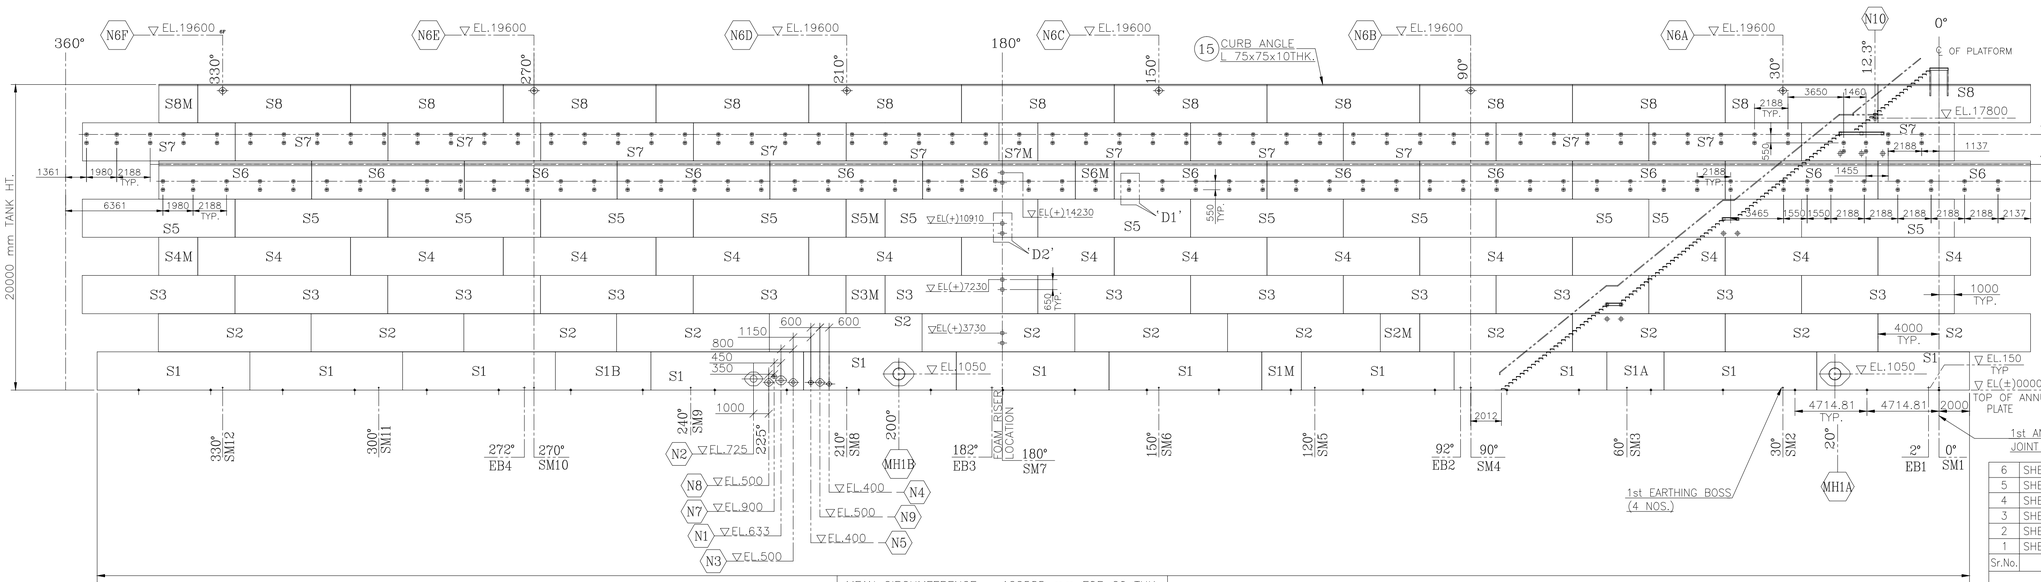

MEAN CIRCUMFERENCE = 122585 mm FOR 20 THK.
MEAN CIRCUMFERENCE = 122579 mm FOR 18 THK.
MEAN CIRCUMFERENCE = 122566 mm FOR 14 THK.
MEAN CIRCUMFERENCE = 122560 mm FOR 12 THK.
MEAN CIRCUMFERENCE = 122554 mm FOR 10 THK.
MEAN CIRCUMFERENCE = 122547 mm FOR 8 THK.

SHELL PLATE LAYOUT
(SCALE-1:200)

NOTES :

1. ALL DIMENSIONS ARE IN mm, UNLESS OTHERWISE SPECIFIED
2. FOR GENERAL NOTES, REFER GENERAL ARRANGEMENT DWG. NO. : 13B1A46-00-02-GA-501.
3. ALL TEMPORARY ATTACHMENTS SHALL BE REMOVED (NO REDUCTION IN PLATE THICKNESS ALLOWED) & WELDS ON REMOVED PORTION AROUND SMOOTH & SHALL BE EXAMINED VISUALLY BY PT METHOD AS PER API-650.
4. SHELL INTERNAL HORIZONTAL / VERTICAL WELDING SEAMS SHALL BE SMOOTH WITH NO SHARP ABRUPT EDGES.
5. ALL WELDING TO BE CARRIED OUT AT SITE.
6. CURB ANGLE JOINTS SHALL STAGGER AT LEAST BY 300mm WITH VERTICAL SHELL PLATE WELD.
7. REFER SHEET 1 OF 2 FOR TANK NO. T-03 A FOR SHELL PLATE LAYOUT.

PLATE CUTTING LAYOUT
(SCALE 1:150)

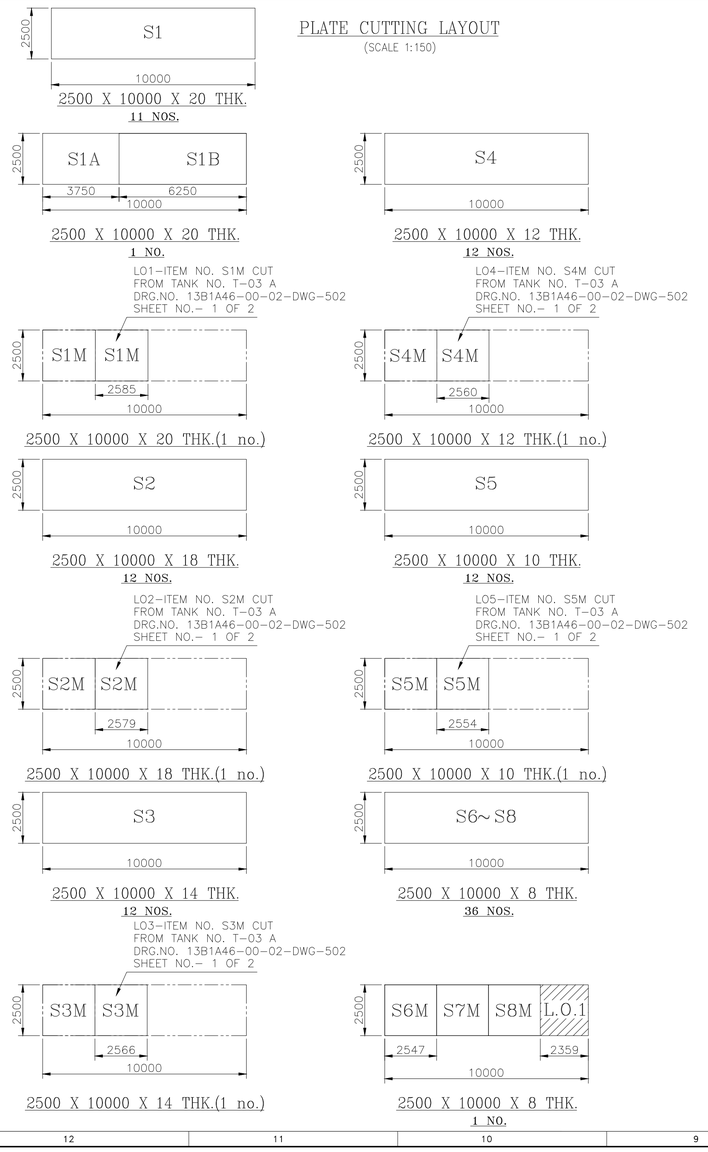

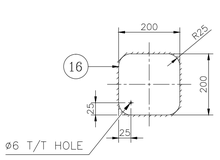

TYP. DETAIL OF PAD PLATE
(SCALE-1:10)

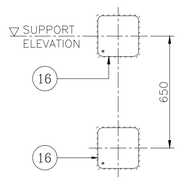

DETAIL 'D2'
(SCALE-1:15)

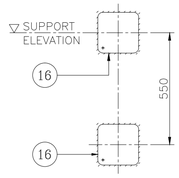

DETAIL 'D1'
(SCALE-1:15)

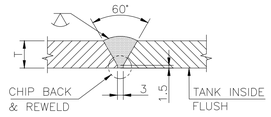

TYP. VERTICAL SEAM WELD FOR 'T' ABOVE 6 mm TO 13 mm.

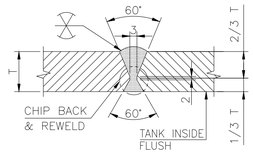

TYP. VERTICAL SEAM WELD FOR 'T' ABOVE 13 mm.

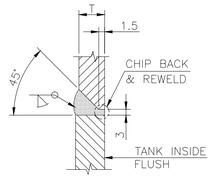

TYP. HORIZONTAL SEAM WELD FOR 'T' ABOVE 6 mm TO 13 mm.

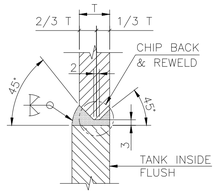

TYP. HORIZONTAL SEAM WELD FOR 'T' ABOVE 13 mm.

TYP. CURB ANGLE WELDING DETAIL

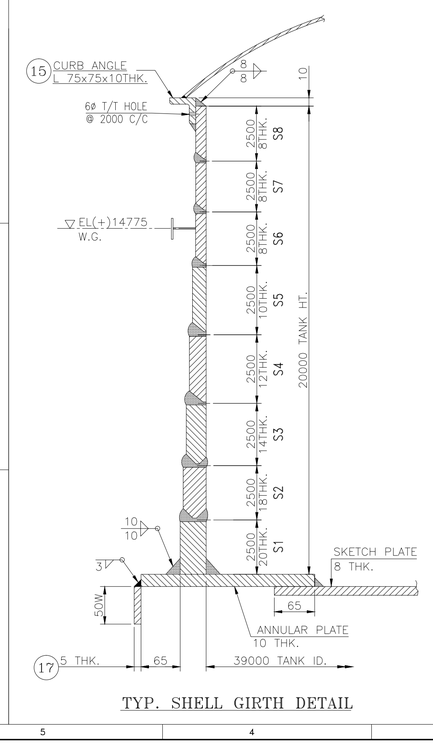

TYP. SHELL GIRTH DETAIL

LIST OF LEFT-OVER PLATES

LEFT-OUT NO.	SIZE	QTY.	MATERIAL	WEIGHT
1	08 THK. x 2500 x 2359	1	IS 2062 GR. B	370.36
			TOTAL WT. IN Kg.	370.36

TOTAL WT. IN Kg. : 232360.00

Sr.No.	DESCRIPTION	QTY.	DIMENSION	MATERIAL	WEIGHT	REMARK
6	SHELL PLATE	37	08 THK x 2500 x 10000	IS 2062 GR. B	58090.00	–
5	SHELL PLATE	12	10 THK x 2500 x 10000	IS 2062 GR. B	23550.00	–
4	SHELL PLATE	12	12 THK x 2500 x 10000	IS 2062 GR. B	28260.00	–
3	SHELL PLATE	12	14 THK x 2500 x 10000	IS 2062 GR. B	32970.00	–
2	SHELL PLATE	12	18 THK x 2500 x 10000	IS 2062 GR. B	42390.00	–
1	SHELL PLATE	12	20 THK x 2500 x 10000	IS 2062 GR. B	47100.00	–

TOTAL PLATE REQUIREMENT FOR ONE TANK

TOTAL WT. IN Kg. : 238046.52

Sr.No.	DESCRIPTION	QTY.	DIMENSION	MATERIAL	WEIGHT	REMARK
17	DRIP RING	1	5 THK. x 50 x ~123071	IS 2062 GR. A	241.52	–
16	PAD PLATE	232	8 THK x 200 x 200	IS 2062 GR. B	582	–
15	CURB ANGLE	1	L75x75x10THK.-122883 LG	IS 2062 GR. A	1351.71	–
14	SHELL PLATE S6M~S8M	3	8 THK x 2500 x 2547	IS 2062 GR. B	1199.64	–
13	SHELL PLATE S6~S8	36	8 THK x 2500 x 10000	IS 2062 GR. B	56520.00	–
12	SHELL PLATE S5M	1	10 THK x 2500 x 2554	IS 2062 GR. B	501.22	–
11	SHELL PLATE S5	12	10 THK x 2500 x 10000	IS 2062 GR. B	23550.00	–
10	SHELL PLATE S4M	1	12 THK x 2500 x 2560	IS 2062 GR. B	602.88	–
9	SHELL PLATE S4	12	12 THK x 2500 x 10000	IS 2062 GR. B	28260.00	–
8	SHELL PLATE S3M	1	14 THK x 2500 x 2566	IS 2062 GR. B	705.01	–
7	SHELL PLATE S3	12	14 THK x 2500 x 10000	IS 2062 GR. B	32970.00	–
6	SHELL PLATE S2M	1	18 THK x 2500 x 2579	IS 2062 GR. B	911.03	–
5	SHELL PLATE S2	12	18 THK x 2500 x 10000	IS 2062 GR. B	42390.00	–
4	SHELL PLATE S1B	1	20 THK x 2500 x 6250	IS 2062 GR. B	2453.12	–
3	SHELL PLATE S1A	1	20 THK x 2500 x 3750	IS 2062 GR. B	1471.87	–
2	SHELL PLATE S1M	1	20 THK x 2500 x 2585	IS 2062 GR. B	1014.61	–
1	SHELL PLATE S1	11	20 THK x 2500 x 10000	IS 2062 GR. B	43175.00	–

BILL OF MATERIAL FOR ONE TANK

REFERENCE DRAWINGS

SR. NO.	DWG TITLE	DWG NO.
1	BOTTOM PLATE LAYOUT	13B1A46-00-02-DWG-501
2	SPIRAL STAIRWAY WITH PLATFORM AND HANDRAIL	13B1A46-00-02-DWG-504 2 SHEETS
3	WIND GIRDER/HANDRAIL DETAIL	13B1A46-00-02-DWG-505
4	SHELL NOZZLE DETAILS	13B1A46-00-02-DWG-507 2 SHEETS
5	SHELL NOZZLE ORIENTATION	13B1A46-00-02-DWG-516 SHT. 2 OF 2

AS BUILT

REV.	DATE	DESCRIPTION	DRAWN	ENG	CHK	APPROVED
F1	05.10.2015	ISSUED AS BUILT	DGK	AS	RAVI	RV
C3	17.14.2014	RE-ISSUED FOR CONSTRUCTION	DJS	AS	RAVI	RV
C2	07.01.2014	RE-ISSUED FOR CONSTRUCTION WITH HOLD	PPS	MP	MP	RV
C1	05.12.2013	ISSUED FOR CONSTRUCTION WITH HOLD	PPS	MP	MP	RV
B1	08.11.2013	ISSUED FOR INFORMATION	PPS	MP	MP	RV

REVISION SUMMARY

PROJECT : COMMON USERS POL TERMINAL LAKHOLI, RAIPUR

OWNER:- IOT INFRASTRUCTURE & ENERGY SERVICES LTD
Glocally Entrepreneurial

EPC CONTRACTOR:- IOT ANWESHA ENGINEERING & CONSTRUCTION LTD.

ENGINEERING CONSULTANT:- IOT DESIGN & ENGINEERING LTD. MUMBAI

PROJ. NO.: SJ-203

TITLE : SHELL PLATE LAYOUT FOR MS PIPELINE RECEIPT STORAGE SINGLE DECK INTERNAL FLOATING ROOF TANKS (39.0 M I.D. x 20.0 M HT.) (T-03 B)

SHEET SIZE : A1

SCALE : AS SHOWN

DWG NO : 13B1A46-00-02-DWG-502

SHEET 2 of 2

REV. F1

FILE NAME : 13B1A46-00-02-GA-502 (T-03A-B-MS Pipeline Receipt storage tank)