SCALE-1:15

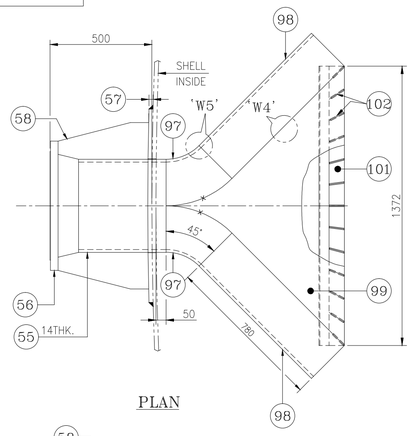

PLAN

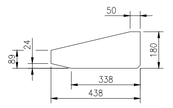

GUSSET 58

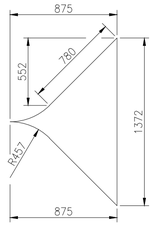

DETAIL OF COVER PLATE 99

SCALE-1:25

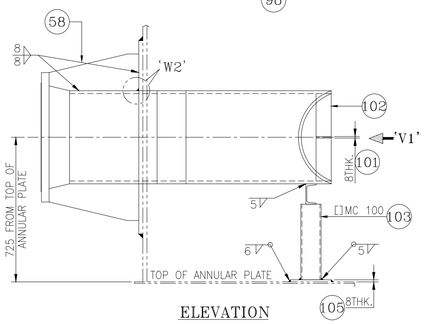

ELEVATION

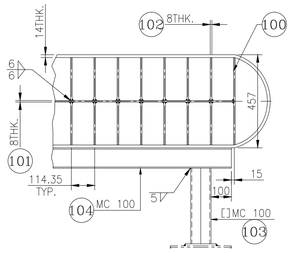

VIEW-V1

N2-OUTLET (PUMP SUCTION)
(18" NB)

SCALE-1:5

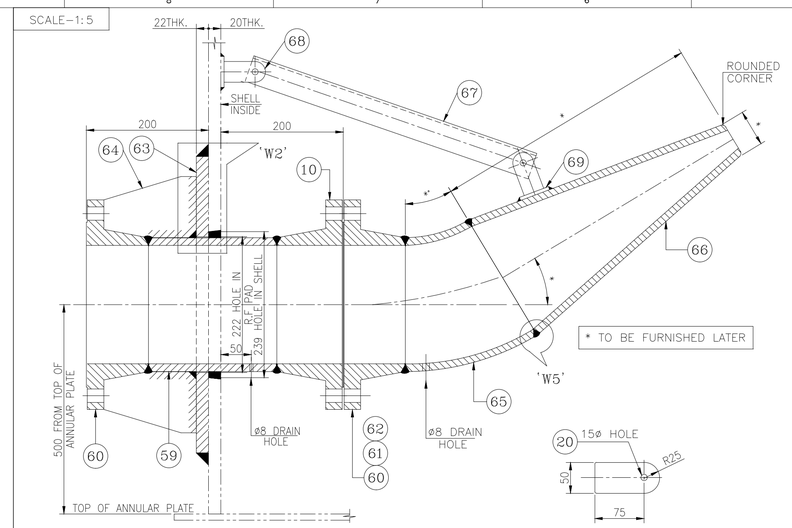

'N3'-JET MIXXING NOZZLE
(8" NB)

PLATE 70

SCALE-1:5

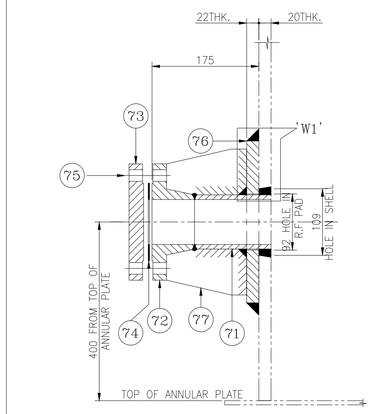

'N4'-SPARE
(3" NB)

NOTES :

1. ALL DIMENSIONS ARE IN mm. UNLESS OTHERWISE SPECIFIED.
2. READ THIS DRAWING IN CONJUNCTION WITH DRG. NO.: 13B1A46-00-02-DWG-507 (SHEET 1 & 3 OF 3).

HOLD :

1. JET MIXER (N3)

TOTAL WT. IN Kg. : 1149

Sr.No.	DESCRIPTION	QTY.	DIMENSION	MATERIAL	WEIGHT	REMARK
105	PAD PLATE	N2	2	8 THK. x 120 x 200	IS-2062 GR.B	3.01	–
104	CHANNEL SUPPORT	N2	1	MC 100 x ~1375 LG.	IS-2062 GR.A	17.21	–
103	CHANNEL SUPPORT	N2	4	MC 100 x ~400 LG.	IS-2062 GR.A	15.11	–
102	RIB	N2	11	8 THK. x 75 x 215	IS-2062 GR.B	11.14	CTS
101	CENTER RIB	N2	1	8 THK. x 75 x 1375 LG.	IS-2062 GR.B	6.48	–
100	RIB	N2	2	10 THK. x 75 x ~430 LG.	IS-2062 GR.B	5.06	–
99	COVER PLATE	N2	2	10 THK. x AS SHOWN	IS-2062 GR.B	75.25	–
98	PIPE (HALF CUT)	N2	2	14 THK. x 780 LG. x 696 W	IS-2062 GR.B	119.32	–
97	BEND	N2	2	18" NB SCH.XS 45° HALF ELBOW	A-234 GR.WPB	82.30	–
96	RIB	N6A-F	48	6 THK. x AS SHOWN	IS: 2062 GR.B	27.36	–
95	NUTS/BOLTS	N6A-F	48	M20 x 115 LG.	A-193 GR.B7/ A-194 GR. 2H	–	GALV.
94	FLANGE	N10	01	2" NB 150# W.N.R.F. SCH.80	A 105	2.70	–
93	NECK	N10	01	2" NB; SCH.80; ~120 LG.	A 106 GR.B	0.9	–
92	RIB	N9	08	6 THK. x AS SHOWN	IS: 2062 GR.B	4.56	–
91	R.F.PAD	N9	01	22 THK. x AS SHOWN	IS: 2062 GR.B	29.15	CTS
90	NUTS/BOLTS	N9	08	M20 x 90 LG.	A-193 GR.B7/ A-194 GR. 2H	–	GALV.
89	GASKET	N9	1+1	3 THK. TO SUIT 8" NB	CNAF	–	–
88	BLIND FLANGE	N9	01	8" NB 150# B.L.R.F.	A 105	20.50	–
87	FLANGE	N9	01	8" NB 150# W.N.R.F. SCH.80	A 105	17.70	–
86	NECK	N9	01	8" NB; SCH.80; ~135 LG.	A 106 GR.B	8.73	–
85	STIFFENER PLATE	N7	02	6 THK. x 40 x ~75 LG	IS: 2062 GR.A	0.28	–
84	FLANGE	N7	01	2" NB 150# W.N.R.F. SCH.80	A 105	2.70	–
83	NECK	N7	01	2" NB; SCH.80; ~125 LG.	A 106 GR.B	0.94	–
82	GASKET	N6A-F	06	3 THK. x TO SUIT TO 8"NB	CNAF	--	G.I
81	PLATE FLANGE	N6A-F	06	343 O/Dx220 I/Dx 10THK	IS: 2062 GR.B	25.62	G.I
82	R.F PAD	N6A-F	06	485 O/Dx222 I/Dx 8THK	IS: 2062 GR.B	55.03	–
79	FLANGE	N6A-F	06	8" NB 150# W.N.F.F. SCH.80	A 105	111.00	–
78	NECK	N6A-F	06	8" NB; SCH.80; ~250 LG.	A 106 GR.B	96.98	–
77	RIB	N4	04	6 THK. x AS SHOWN	IS: 2062 GR.B	1.56	–
76	R.F.PAD	N4	01	22 THK. x AS SHOWN	IS: 2062 GR.B	10.12	CTS
75	NUTS/BOLTS	N4	04	M16 x 80 LG.	A-193 GR.B7/ A-194 GR. 2H	–	GALV.
74	GASKET	N4	01	3 THK. TO SUIT 3" NB	CNAF	–	–
73	BLIND FLANGE	N4	01	3" NB 150# B.L.R.F.	A 105	4.10	–
72	FLANGE	N4	01	3" NB 150# W.N.R.F. SCH.80	A 105	4.60	–
71	NECK	N4	01	3" NB; SCH.80; ~150 LG.	A 106 GR.B	2.29	–
70	BOLTS/NUTS	N3	02	M 12 x 50 LG	A-193 GR.B7/ A-194 GR. 2H	–	GALV.
69	PAD PLATE	N3	02	8 THK. x 75 x 75	IS: 2062 GR.B	0.70	–
68	PLATE	N3	02	8 THK. x AS SHOWN	IS: 2062 GR.B	0.65	–
67	SUPPORT ANGLE	N3	01	L65 x 65 x 8THK.x490 LG.	A 105	2.84	–
66	REDUCER	N3	01	– HOLD	IS: 2062 GR.B	--	–
65	ELBOW	N3	01	8" NB x SCH.80 x 45° L.R.	A 234 GR WPB	12.32	CTS
64	RIB	N3	08	6 THK. x AS SHOWN	IS: 2062 GR.B	4.56	–
63	R.F.PAD	N3	01	22 THK. x AS SHOWN	IS: 2062 GR.B	29.15	CTS
62	NUTS/BOLTS	N3	08	M20 x 90 LG.	A-193 GR.B7/ A-194 GR. 2H	–	GALV.
61	GASKET	N3	1+1	3 THK. TO SUIT 8" NB	CNAF	–	–
60	FLANGE	N3	03	8" NB 150# W.N.R.F. SCH.80	A 105	53.10	–
59	NECK	N3	01	8" NB; SCH.80; 216 LG.	A 106 GR.B	13.96	–
58	RIB	N2	08	6 THK. x AS SHOWN	IS: 2062 GR.B	24	–
57	R.F.PAD	N2	01	22 THK. x AS SHOWN	IS: 2062 GR.B	110	CTS
56	FLANGE	N2	01	18" NB 150# W.N.R.F. SCH.XS	A 105	68.00	–
55	NECK	N2	01	14 THK. x 440W x 1395 LG.	IS: 2062 GR.B	67.50	–
54	DELETED	–	–	–	–	–	–
53	DELETED	–	–	–	–	–	–
52	DELETED	–	–	–	–	–	–
51	DELETED	–	–	–	–	–	–

BILL OF MATERIAL FOR ONE TANK

SCALE-1:10

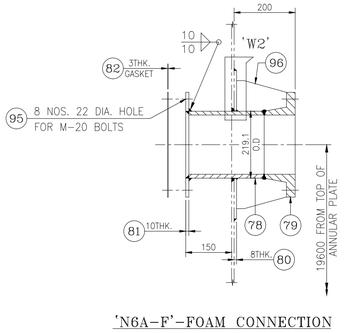

'N6A-F'-FOAM CONNECTION
(8" NB)

SCALE-1:3

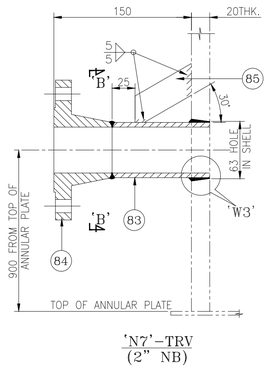

'N7'-TRV
(2" NB)

SCALE-1:5

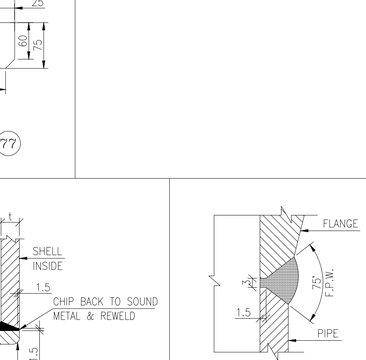

'N9'-SPARE
(8" NB)

SCALE-1:3

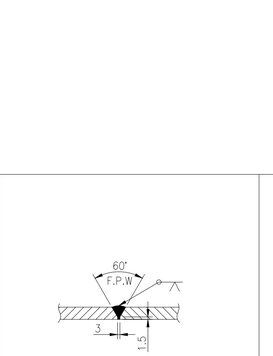

'N10'-LEVEL SWITCH
(2" NB)

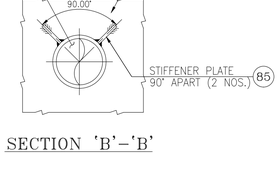

SECTION 'B'-'B'

SCALE-1:5

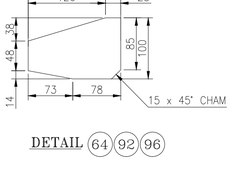

DETAIL 64 92 96

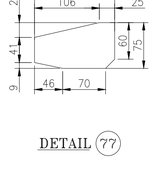

DETAIL 77

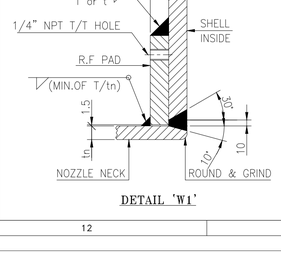

DETAIL 'W1'

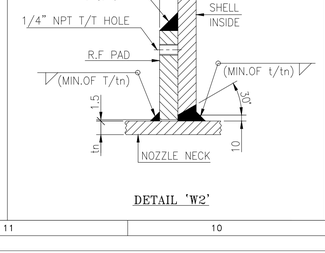

DETAIL 'W2'

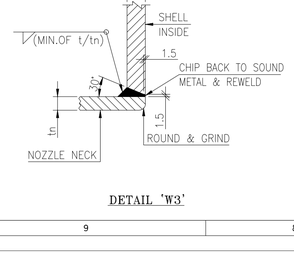

DETAIL 'W3'

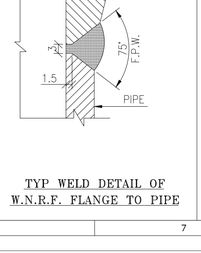

TYP WELD DETAIL OF
W.N.R.F. FLANGE TO PIPE

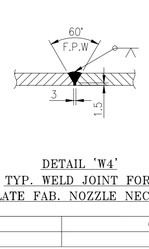

DETAIL 'W4'
TYP. WELD JOINT FOR
PLATE FAB. NOZZLE NECKS

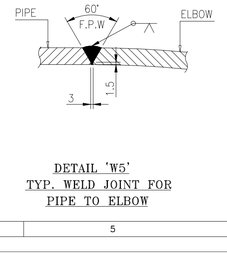

DETAIL 'W5'
TYP. WELD JOINT FOR
PIPE TO ELBOW

AS BUILT

REV.	DATE	DESCRIPTION	DRAWN	ENG	CHK	APPROVED
F1	05.10.2015	ISSUED AS BUILT	DGK	AS	RAVI	RV
C3	23.06.2014	ISSUED FOR CONSTRUCTION WITH HOLD	PPS	AS	RAVI	RV
C2	05.03.2014	ISSUED FOR CONSTRUCTION WITH HOLD	RAVI	MP	MP	RV
C1	10.02.2014	ISSUED FOR CONSTRUCTION WITH HOLD	SSK	MP	MP	RV

REVISION SUMMARY

PROJECT :
COMMON USERS POL TERMINAL
LAKHOLI, RAIPUR, CHATTISGARH

OWNER:-
IOT INFRASTRUCTURE & ENERGY SERVICES LTD
Glocally Entrepreneurial

EPC CONTRACTOR:-
IOT ANWESHA ENGINEERING & CONSTRUCTION LTD.

ENGINEERING CONSULTANT:-
IOT DESIGN & ENGINEERING LTD.
MUMBAI

PROJ. NO.: SJ-203
SHEET SIZE : A1
SCALE : AS SHOWN

TITLE :
DETAILS OF SHELL APPURTENANCES FOR MS PIPELINE RECEIPT STORAGE SINGLE DECK INTERNAL FLOATING ROOF TANKS (39.0 M I.D. x 20.0 M HT.) (T-03 A/B)

DWG NO : 13B1A46-00-02-DWG-507

SHEET 2 OF 3

REV. F1

FILE NAME : 13B1A46-00-02-DWG-507-2 (SX. for T-03A-B)